

-6-75.5 Standard Development Application

(Page 1 of 3)

Indicate to which Board application is being made:

☒ Board of Adjustment

Proposed 6' PVC Fence encroaches front yard setback on corner lot along Garfield Place. 10 min and 0' proposed. R-5 zone

- ## 1. Applicant

2. Property Owner (if other than applicant)

3. Applicant's Attorney (if applicable)

Name:	N/A		Address:		N/A	
City:	N/A	State:	N/A	Zip:	N/A	Phone:
						Fax:
						N/A

BOROUGH OF SAYREVILLE

Standard Development Application

(Page 2 of 3)

4. Subject Property (attach additional sheets if necessary)

Street Address:		Block(s) Lot(s) Number(s):	
105 ROOSEVELT Boulevard		Block 355, Lot 132.01	
Site Acreage (and Sq. Ft.)	Zone District(s)	Tax Sheet Numbers	
50x100 Ft 5,000sqft	R5	N/A	
Present Use			

Single Family - Residential

Proposed Development Name and Nature of Use:

Fence installation on Residential single family home

Number of New Buildings: N/A	Sq. Ft. of New Building(s): N/A	Height N/A	% of Lot to be covered by Building(s): N/A
% of Lot to be Covered by Pavement: % N/A	Number of Parking Spaces and Dimensions: N/A		
Exterior Construction Material/Design: N/A			

N/A

Total Cost of Bldg. And Site Improvements: N/A	Number of Lots Before Subdivision: N/A	Number of Lots After Subdivision: N/A	Are any new streets or utility extensions Proposed: N/A
Number of existing trees 2" caliper or greater to be removed: N/A	Are any structures to be removed? N/A	Number of Proposed Signs and Dimensions:	

Is soil removal or fill proposed? Specify total
in cubic yards: N/A

Is the property within 200 ft. or an adjacent
municipality? If so, which?

5. Are there any existing or proposed deed restrictions or covenants? Please detail.

N/A

6. HISTORY OF PAST APPROVALS

☐ Check here if none

	APPROVED	DENIED	DATE
SUBDIVISION	N/A	N/A	N/A
SITE PLAN			
VARIANCE(S)			
BUILDING PERMIT			

BOROUGH OF SAYREVILLE

Standard Development Application

(Page 3 of 3)

7. NAMES OF PLAN PREPARERS

Engineer's Name:		Address:	
N/A		N/A	
City:	State:	Zip:	Phone:
N/A	N/A	N/A	N/A
Surveyor's Name:		License #:	
N/A		N/A	
City:	State:	Zip:	Phone:
N/A	N/A	N/A	N/A
Landscape Architect or Architect's Name:		License #:	
N/A		N/A	
City:	State:	Zip:	Phone:
N/A	N/A	N/A	N/A

8. FEES SUBMITTED

Application Fees	\$ 50.00
Variance Fees	
Escrow Fees	
Total Fees	\$ 50.00

CERTIFICATION:

I certify that the foregoing statements and the materials submitted are true. I further testify that I am the individual applicant or that I am an Officer of the Corporate applicant and that I am authorized to sign the application for the corporation or that I am a general partner of the partnership applicant. I hereby permit authorized Borough officials to inspect my property in conjunction with this application.

Sworn and subscribed before me this date:

6-30-2020

Aliparo

Signature of Applicant




Property Owner Authorizing Application if Other than Applicant

Notary Public

AS-BUILT PLAN

BOROUGH OF SAYREVILLE MIDDLESEX COUNTY, NEW JERSEY
TAX MAP LOT 67 BLOCK 355

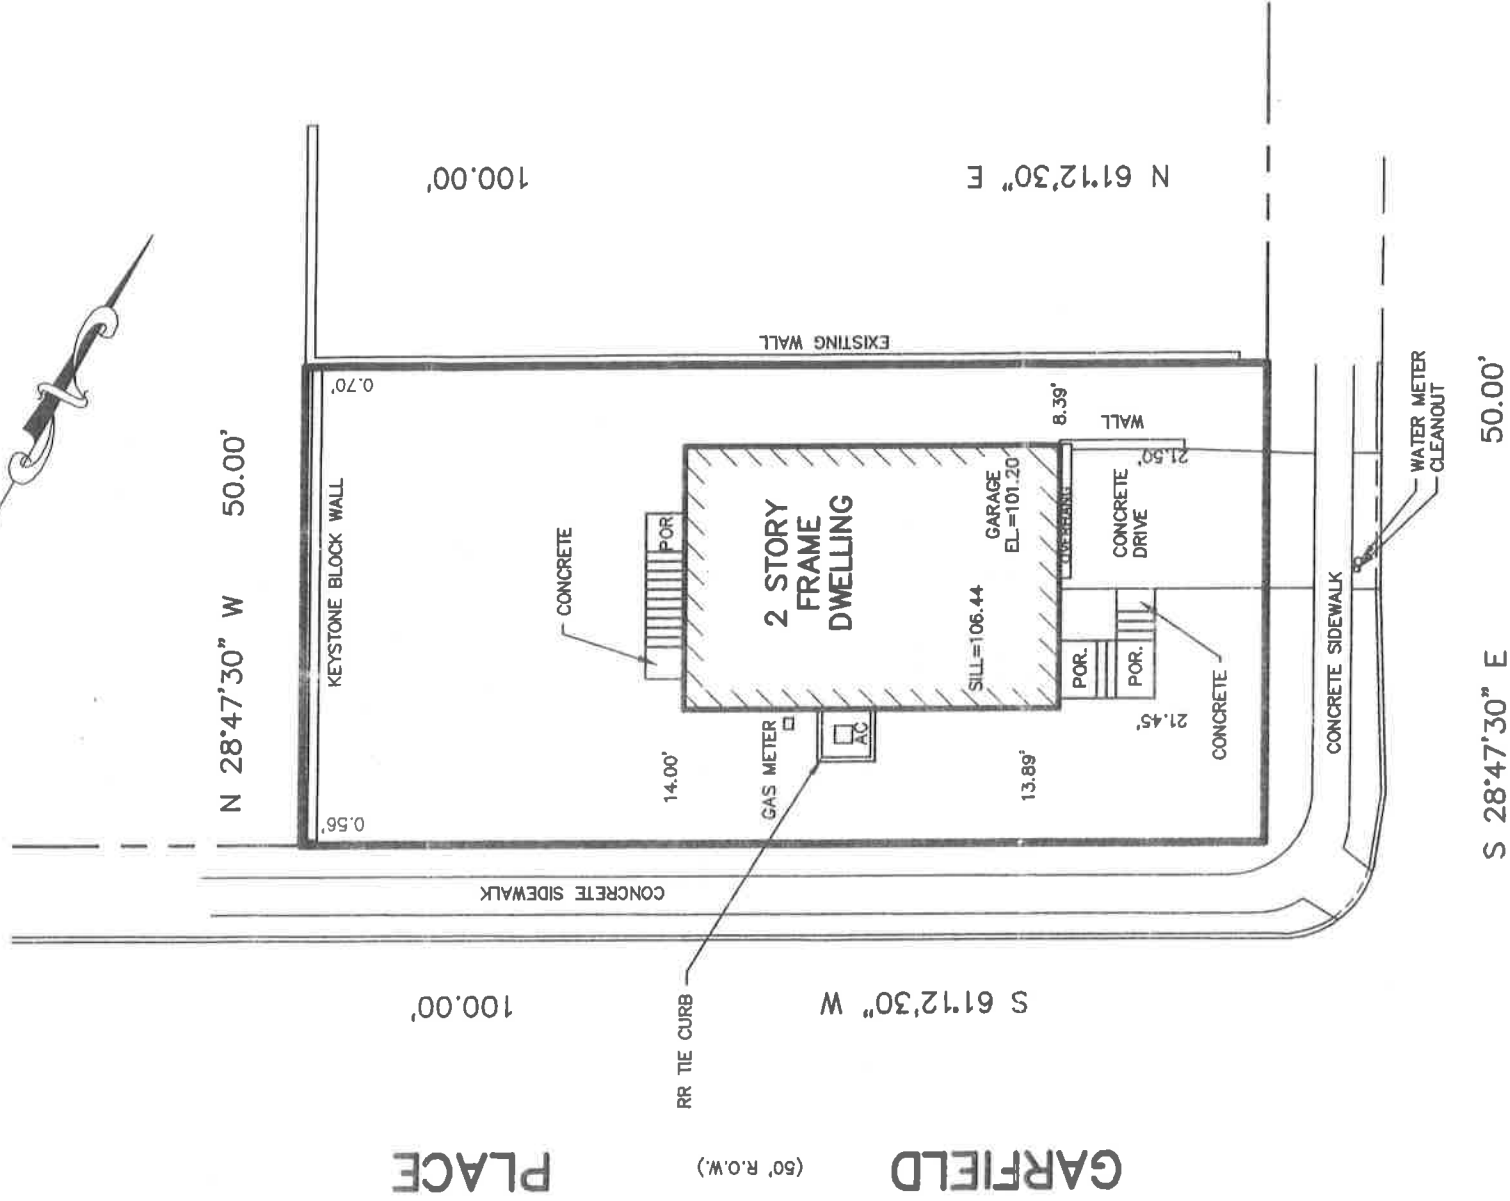

ROOSEVELT

(60' R.O.W.)

BOULEVARD

THIS PLAN IS CERTIFIED TO

PARKER

ENGINEERING & SURVEYING P.C.
370 EAST MAIN STREET, SOMERVILLE, N.J. 08876
(908) 725 - 4400 - FAX (908) 722 - 4401

Daniel E. Parker

DANIEL E. PARKER
NEW JERSEY LAND SURVEYOR NO.35866

DATE

2/6/18

SCALE

1"=20'

FILE

12522