


SITE PHOTO

PHOTO TAKEN BY
GTS CONSULTANTS, INC.
ON 11/6/2009

GENERAL NOTES AND REFERENCES:

1. THIS MAP IS AN AS-BUILT TOPOGRAPHIC SURVEY FOR THE WIRELESS COMPOUND AND GRAVEL ACCESS DRIVE TO THE EXISTING ASPHALT PARKING LOT. EXISTING FEATURES OUTSIDE THESE LIMITS ARE SHOWN IN ACCORDANCE WITH THE SURVEY BY FRENCH & PARRELLO REFERENCED BELOW.
2. SURVEY REFERENCE: "SURVEY OF LOT 1.03, BLOCK 254," PREPARED BY FRENCH & PARRELLO ASSOCIATES ON JANUARY 30, 2007.
3. BLOCK AND LOT NUMBERS ARE SHOWN IN ACCORDANCE WITH THE BOROUGH OF SAYREVILLE TAX MAPS, SHEET No. 89.
4. ALL ELEVATIONS ARE SHOWN IN THE NORTH AMERICAN VERTICAL DATUM OF 1988 (NAVD'88) DERIVED FROM GPS OBSERVATIONS.
5. UNDERGROUND UTILITIES ARE NOT PART OF THIS SURVEY. UTILITIES SHOWN ARE BASED ON VISIBLE SURFACE FEATURES.

No.	Date	Revision	DRWN BY	CHKD BY

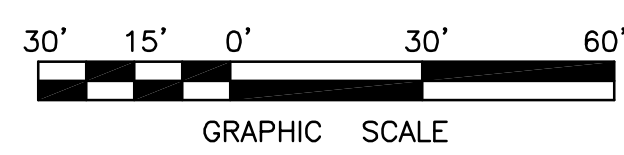

FREDRICK L. VOSS
New Jersey Professional Engineer License No. 25797
and Land Surveyor

GTS CONSULTANTS
Engineering and Surveying
30 Broad Street
Freehold, New Jersey 07728
State of New Jersey Certificate of Authorization 24GA28021900 (732) 409-0900 Fax (732) 409-0927

AS-BUILT CONDITIONS MAP
LOT 1.03 BLOCK 254
WASHINGTON ROAD
BOROUGH OF SAYREVILLE
MIDDLESEX COUNTY NEW JERSEY

INNOVATIVE JOB NO. 9625.006	
DATE: 11/6/2009	SCALE: 1" = 30'
DRAWN: SC	CHECKED: F.L.V.
FILE NAME: 08-186.dwg	PROJECT: 08-186
1 of 1	